


SHEET 1 OF 3

LEMON BAYVIEW VILLAS

A CONDOMINIUM


EXHIBIT "A"

PHASE I - EXISTING

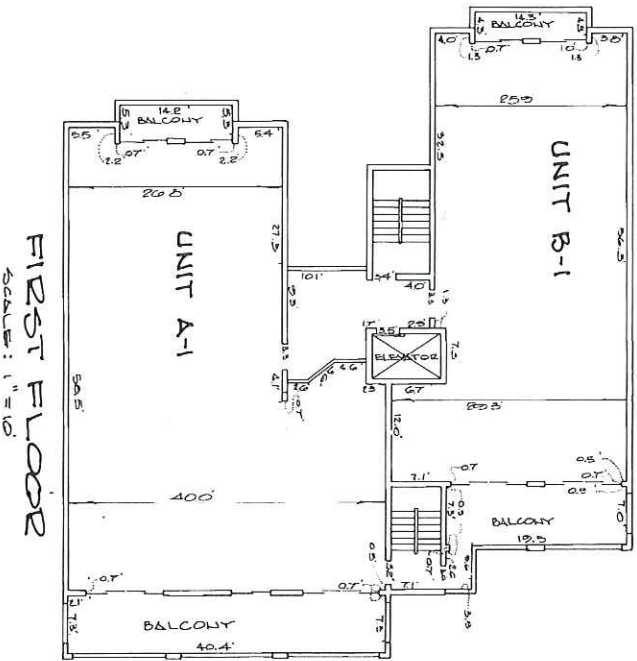


GRAPHIC SCALE 1" = 10'

0 2 4 6 8 10 12 14 16 18 20 22 24 26 28 30

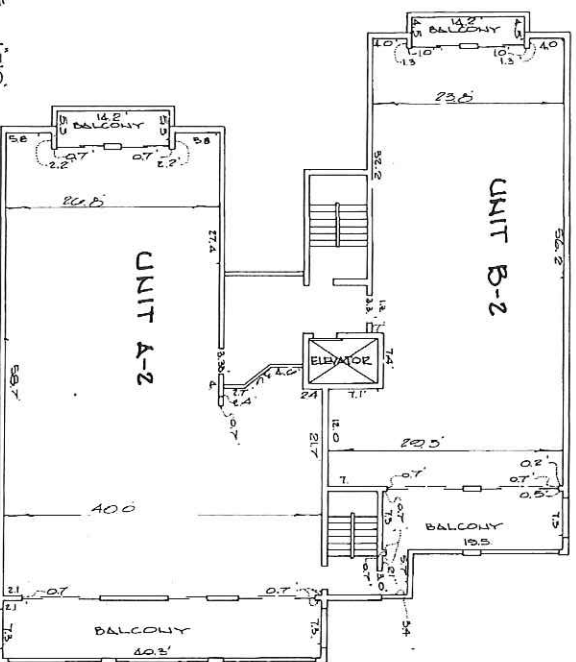

SURVEYOR'S NOTATIONS

1. REPOSED DIMENSIONS ARE SHOWN TO THE NEAREST ONE-HUNDRETH FOOT (0.00').
2. AS-BUILT DIMENSIONS ARE SHOWN TO THE NEAREST ONE-TENTH FOOT (0.1').
3. C.E. DENOTES COMMON ELEMENT.
4. ALL ELEVATIONS SHOWN HEREON ARE BASED ON N.G.V.D.

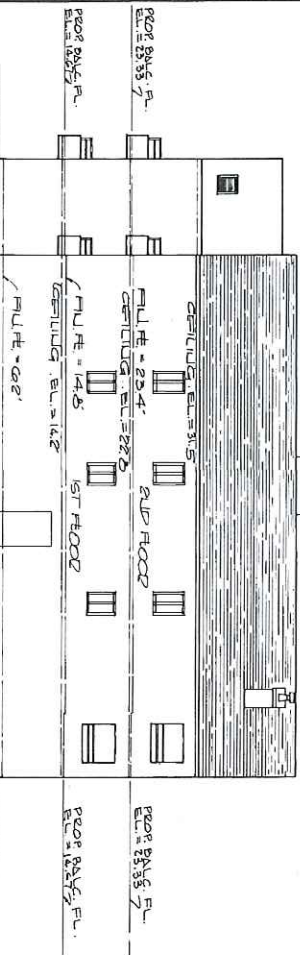

PREPARED BY: DIVERS, McLEOD & KOKOMOOR - 4315 McCALL ROAD - ENGLEWOOD, FLORIDA 33533 (813) 475-6596 JOB NO. 8542

SHEET 2 OF 3

LEMON BAYVIEW VILLAS


A CONDOMINIUM

EXHIBIT A


PHASE II - THIS FILING

CONDOMINIUM BOOK 28 PAGE 14-C

FIRST FLOOR
SCALE 1"=10'

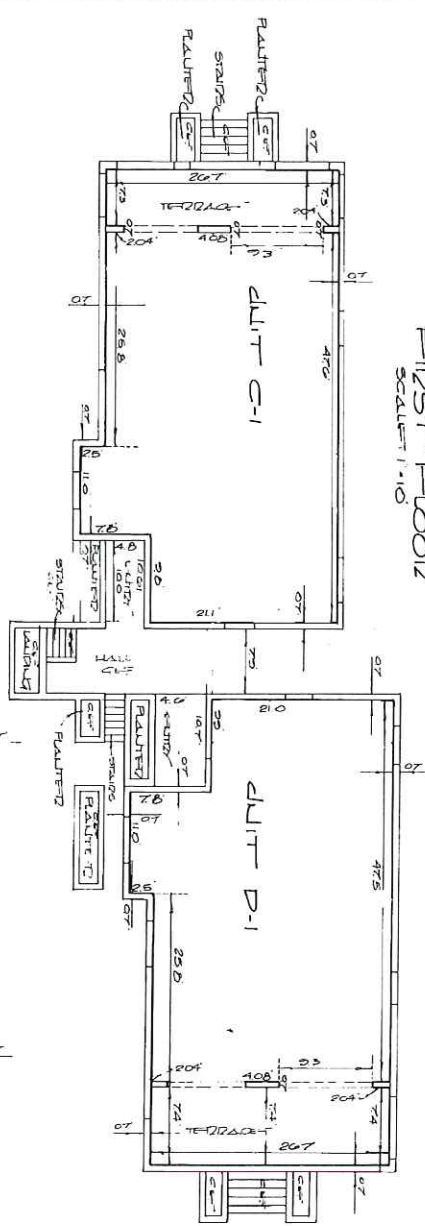

SECOND FLOOR
SCALE 1"=10'

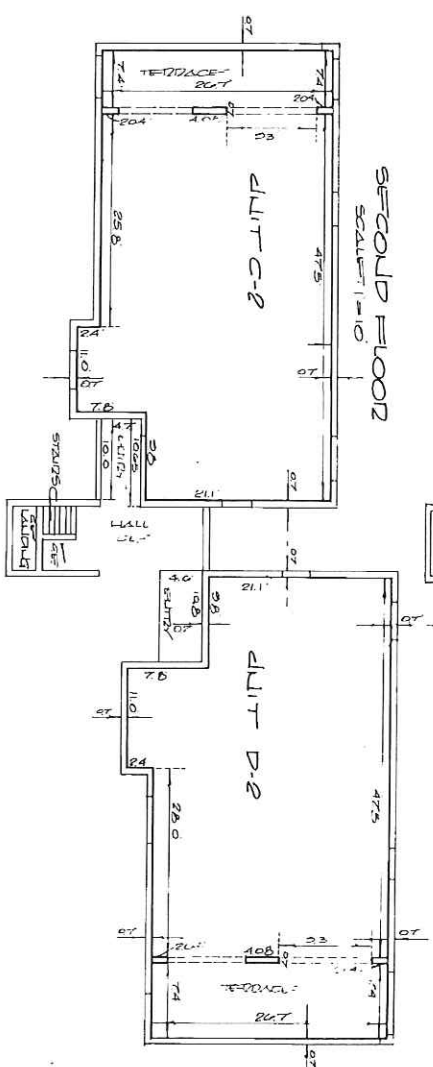

SEVERAL LOTATIONS:
1) AS BUILT DIMENSIONS ARE SHOWN TO THE
NEAREST ONE-EIGHTH FOOT (0.06)
2) CISTERNES COMMON ELEMENTS
3) CISTERNES LIMITED COMMON ELEMENTS
4) ELEVATIONS BASED ON 14'0"

