
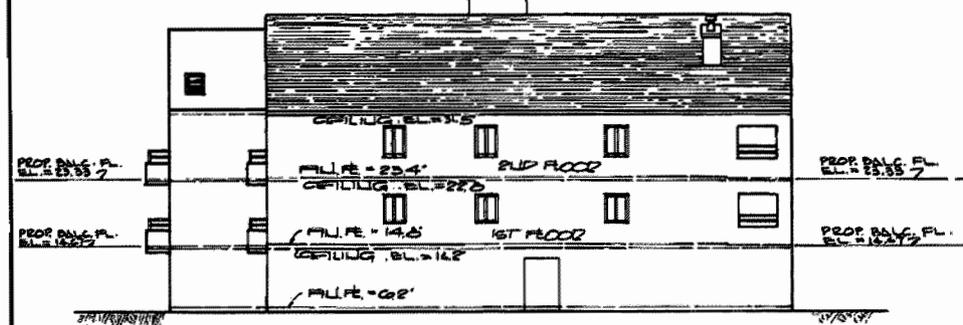
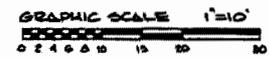
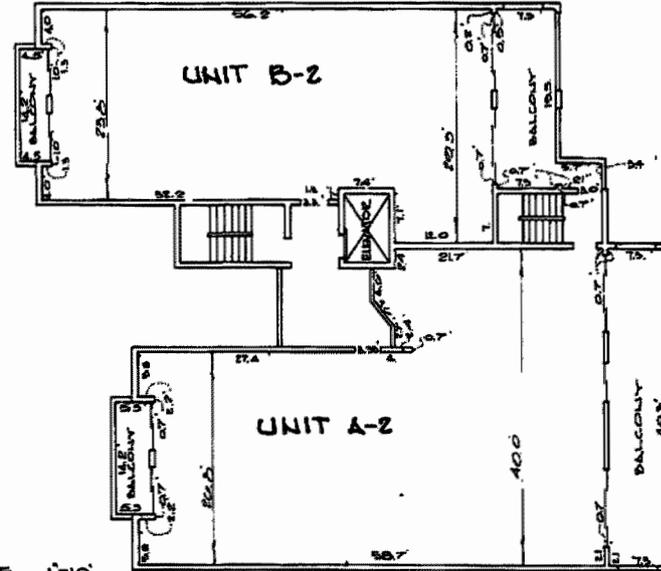



LEMON BAYVIEW VILLAS A CONDOMINIUM EXHIBIT "A" PHASE I - EXISTING

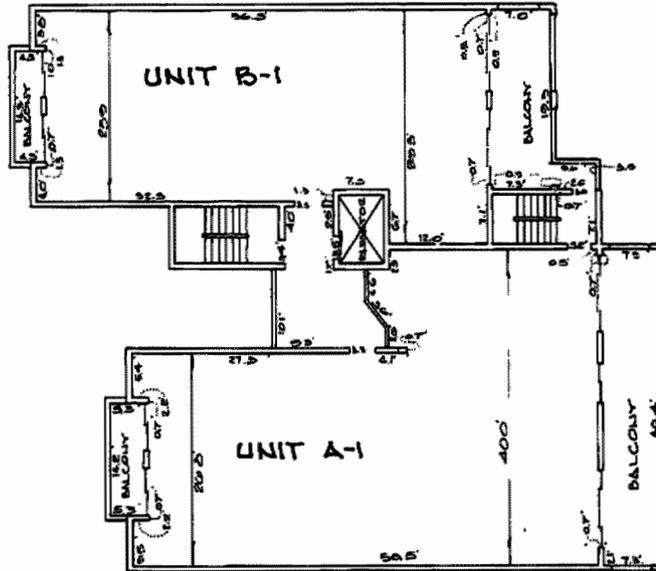


- SURVEYORS NOTATIONS**
1. PROPOSED DIMENSIONS ARE SHOWN TO THE NEAREST ONE-HUNDRETH FOOT (0.00)'
 2. AS BUILT DIMENSIONS ARE SHOWN TO THE NEAREST ONE-TENTH FOOT (0.0)'
 3. C.E. DENOTES COMMON ELEMENT.
 4. ALL ELEVATIONS SHOWN HEREON ARE BASED ON N.G.V.D.

INSTR. #: 3605360 PAGE: 29 OF 47

LEMON BAYVIEW VILLAS A CONDOMINIUM EXHIBIT A PHASE II - THIS FILING

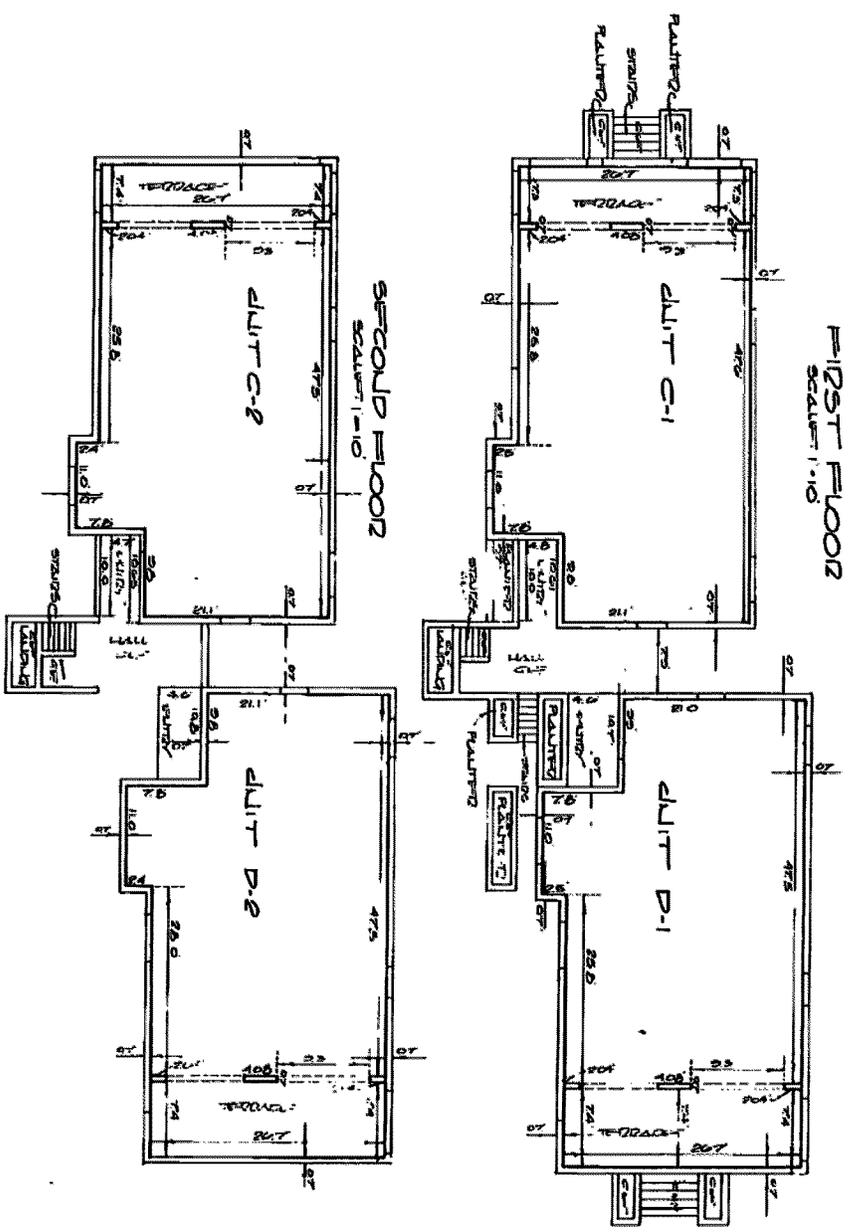

OWNER'S NOTES:
 1) AS BUILT DIMENSIONS ARE SHOWN TO THE
 CENTERLINE OF WALLS AND DOOR (S)
 2) SEE BUILDING CONTROL FURNISHING
 3) LEASE DIMENSIONS UNLESS CONTROL FURNISHING
 4) ELEVATIONS BASED ON MVD

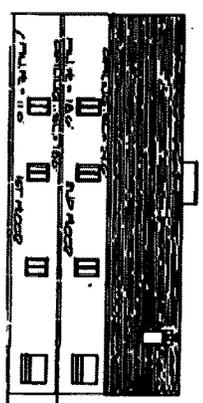

PREPARED BY: INVENTS, INC. 4155 PACIFIC ROAD, PALM BEACH GARDENS, FLORIDA 33484 (561) 473-0200
 DRAWN BY: DTS
 SHEET 3 OF 3